


**LEGEND**

- LWL
- HWL
- Minor Contour
- Major Contour
- 10 Ton Anchor
- 5 Ton Anchor
- 2 Ton Lock Block
- 12mm Amsteel Blue
- 22mm Amsteel Blue
- 25mm Amsteel Blue
- 25mm Long-Link Chain
- 25mm Polysteel Rope
- 32mm M/C Double Braid
- 38mm Long-Link Chain
- 38mm M/C Double Braid
- 50mm M/C Double Braid
- 50mm SuperDan Rope

**NOTES**

- Mooring line information tabled in drawings 4077-35/36-01.
- Contours drawn from Navigation Chart Reference (NobelTec).
- Anchors located using dGPS +/- 2m.
- Mooring lines connected to concrete float in location shown with steel locking plate as per Detail A on drawing 4077-30-01.
- Only mooring lines associated with quad concrete float highlighted for clarity.

Parking Area

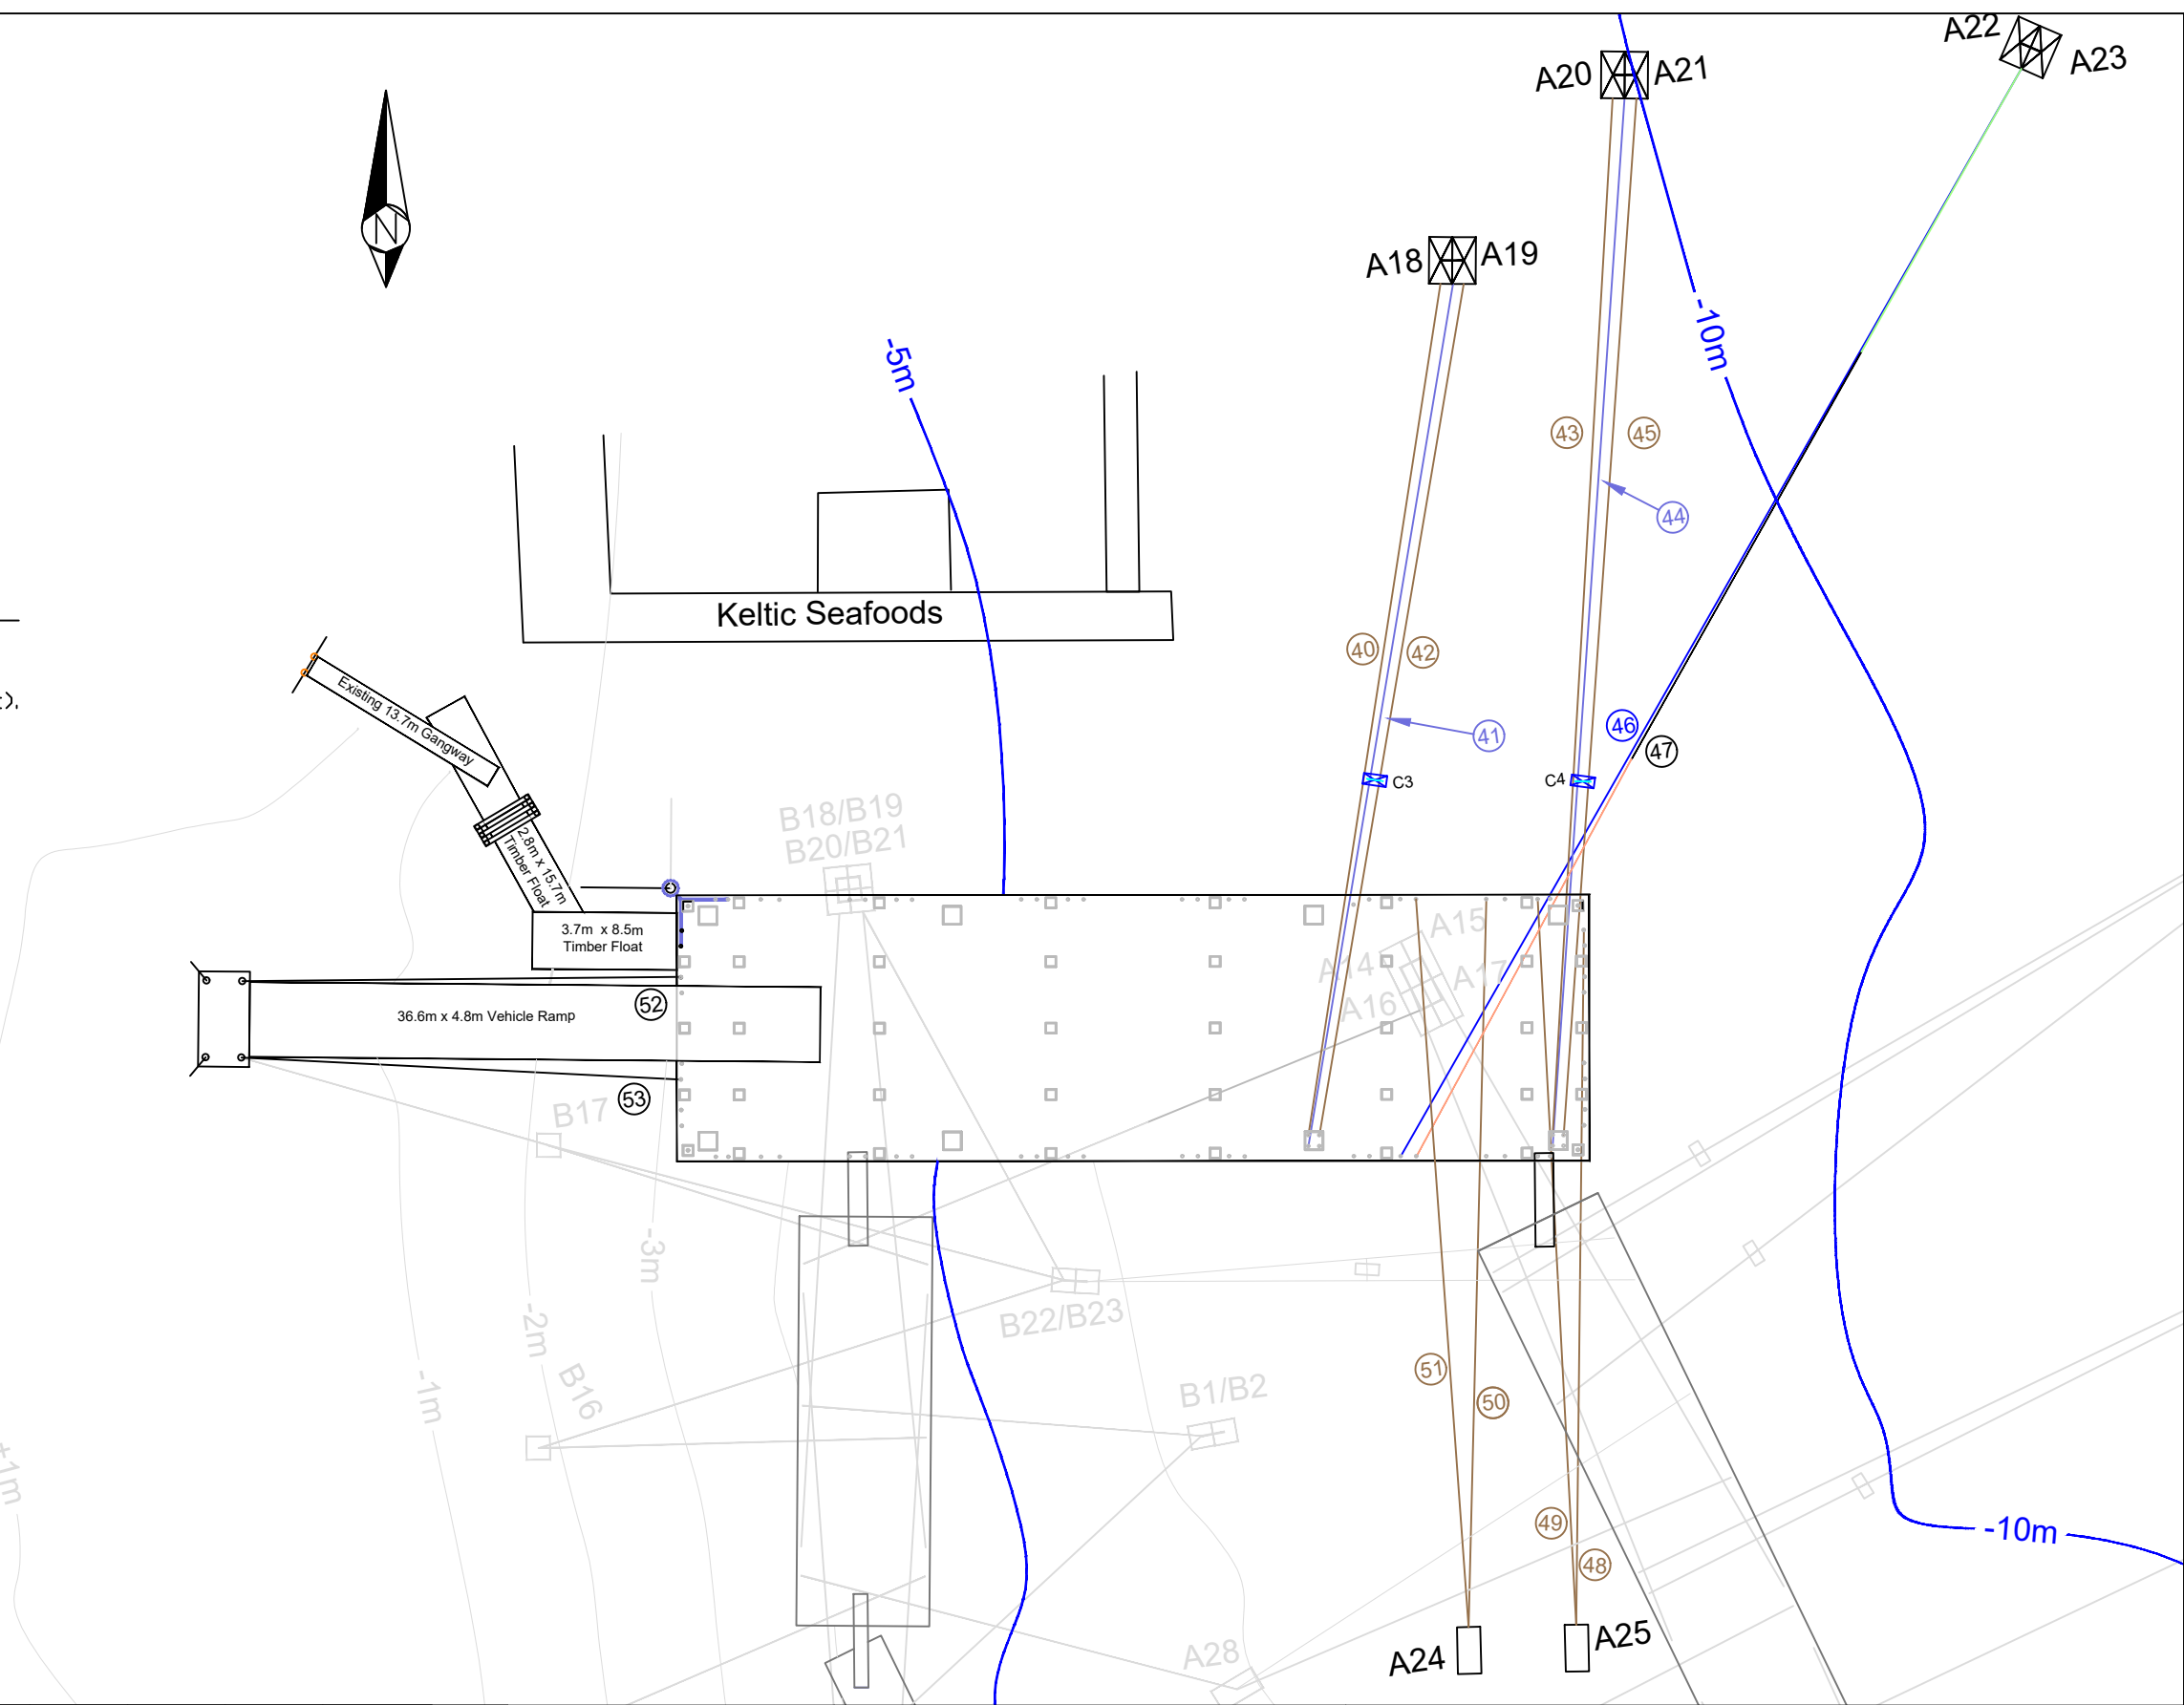

REV	DESCRIPTION	DATE	PLN	DRWN	APPRV	AUTHOR
REFERENCES		AUTHOR		DATE		
CA353503 Hydrographic Data (NobelTec 7.1.900)						

**IP Consulting**  
 INTEGRATED PLANNING  
 2933 Panorama Drive  
 North Vancouver, B.C. V7G 2A4  
 Tel: 604 788 7789

CLIENT  
**District of Port Hardy**  
 7360 Columbia  
 Box 68, Port Hardy, BC V0N 2P0

TITLE		
Quad Float Mooring Layout Port Hardy Seine Harbour Port Hardy, British Columbia		
SIZE	DWG NO.	REV
11 x 17	4077-31-R1	1
SCALE	DATE	SHEET
1:500	2008-10-08	2 of 6